


PROFILE	SURVEYED	BY	DATE
NOTE BOOK	PLOTTED	B. SLICE	10-81
368	GRADES CHECKED	JONES	12-81
	B. M.'s NOTED		

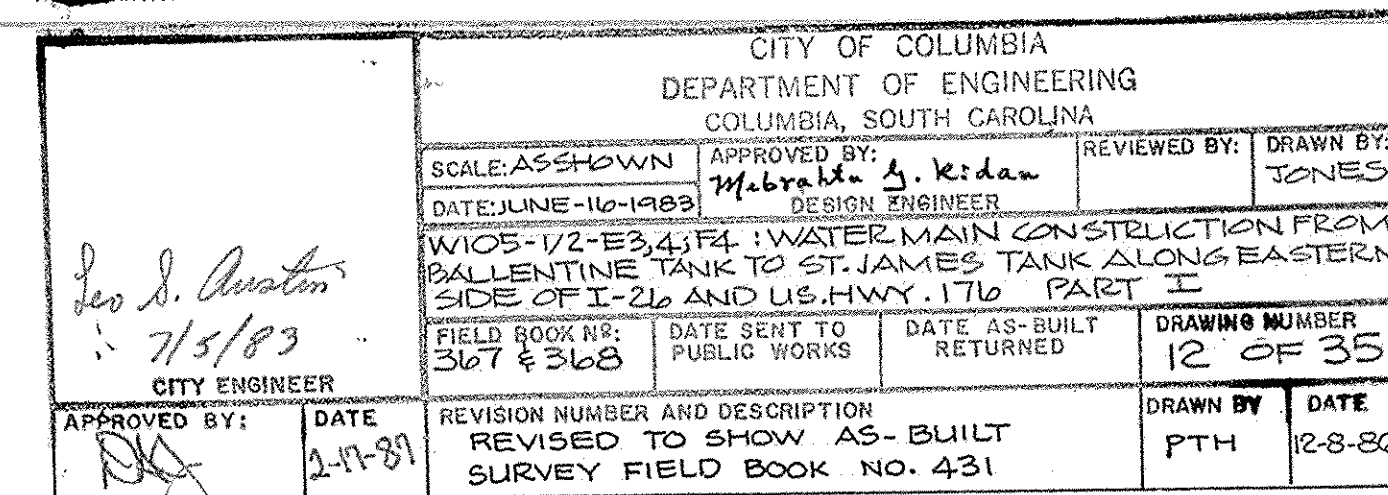


NOTES

1.) CONSTRUCTION & TO RUN 7.5' INSIDE FL

SCALE: HORIZONTAL : 1" = 50'
VERTICAL : 1" = 5'

BENCH MARKS : CHISELED SQ. ON S.W.
COR. WING WALL @ I-26 OVER PASS
ON HWY. S-40-58
ELEV. = 424.97 MSL

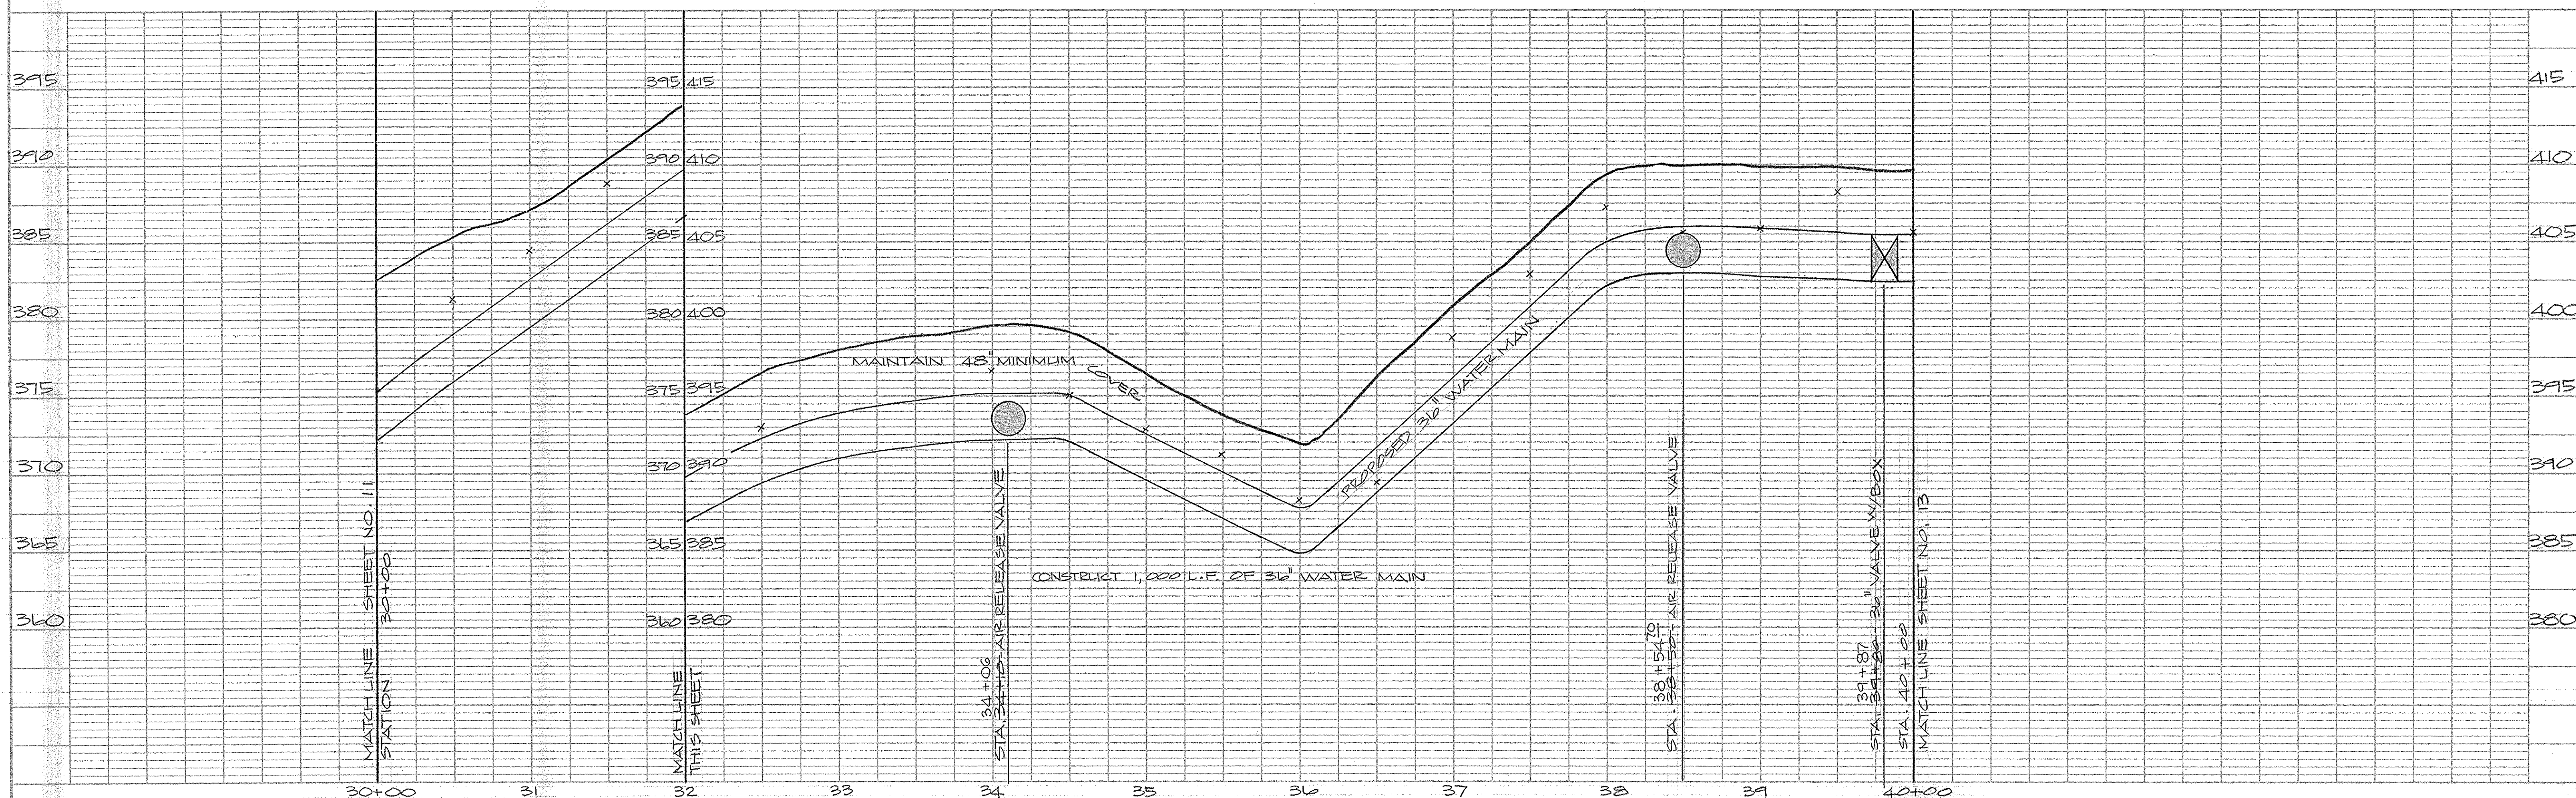

160-12

W105-1/2-E3, 4; F4
SHEET 12 OF 35
AS-BUILT.