


PLAN	DATE	BY
SURVEYED		
PLOTTED		
NOTE BOOK		
NO. 184		

PROFILE	DATE	BY
SURVEYED		
PLOTTED		
NOTE BOOK		
NO. 184		

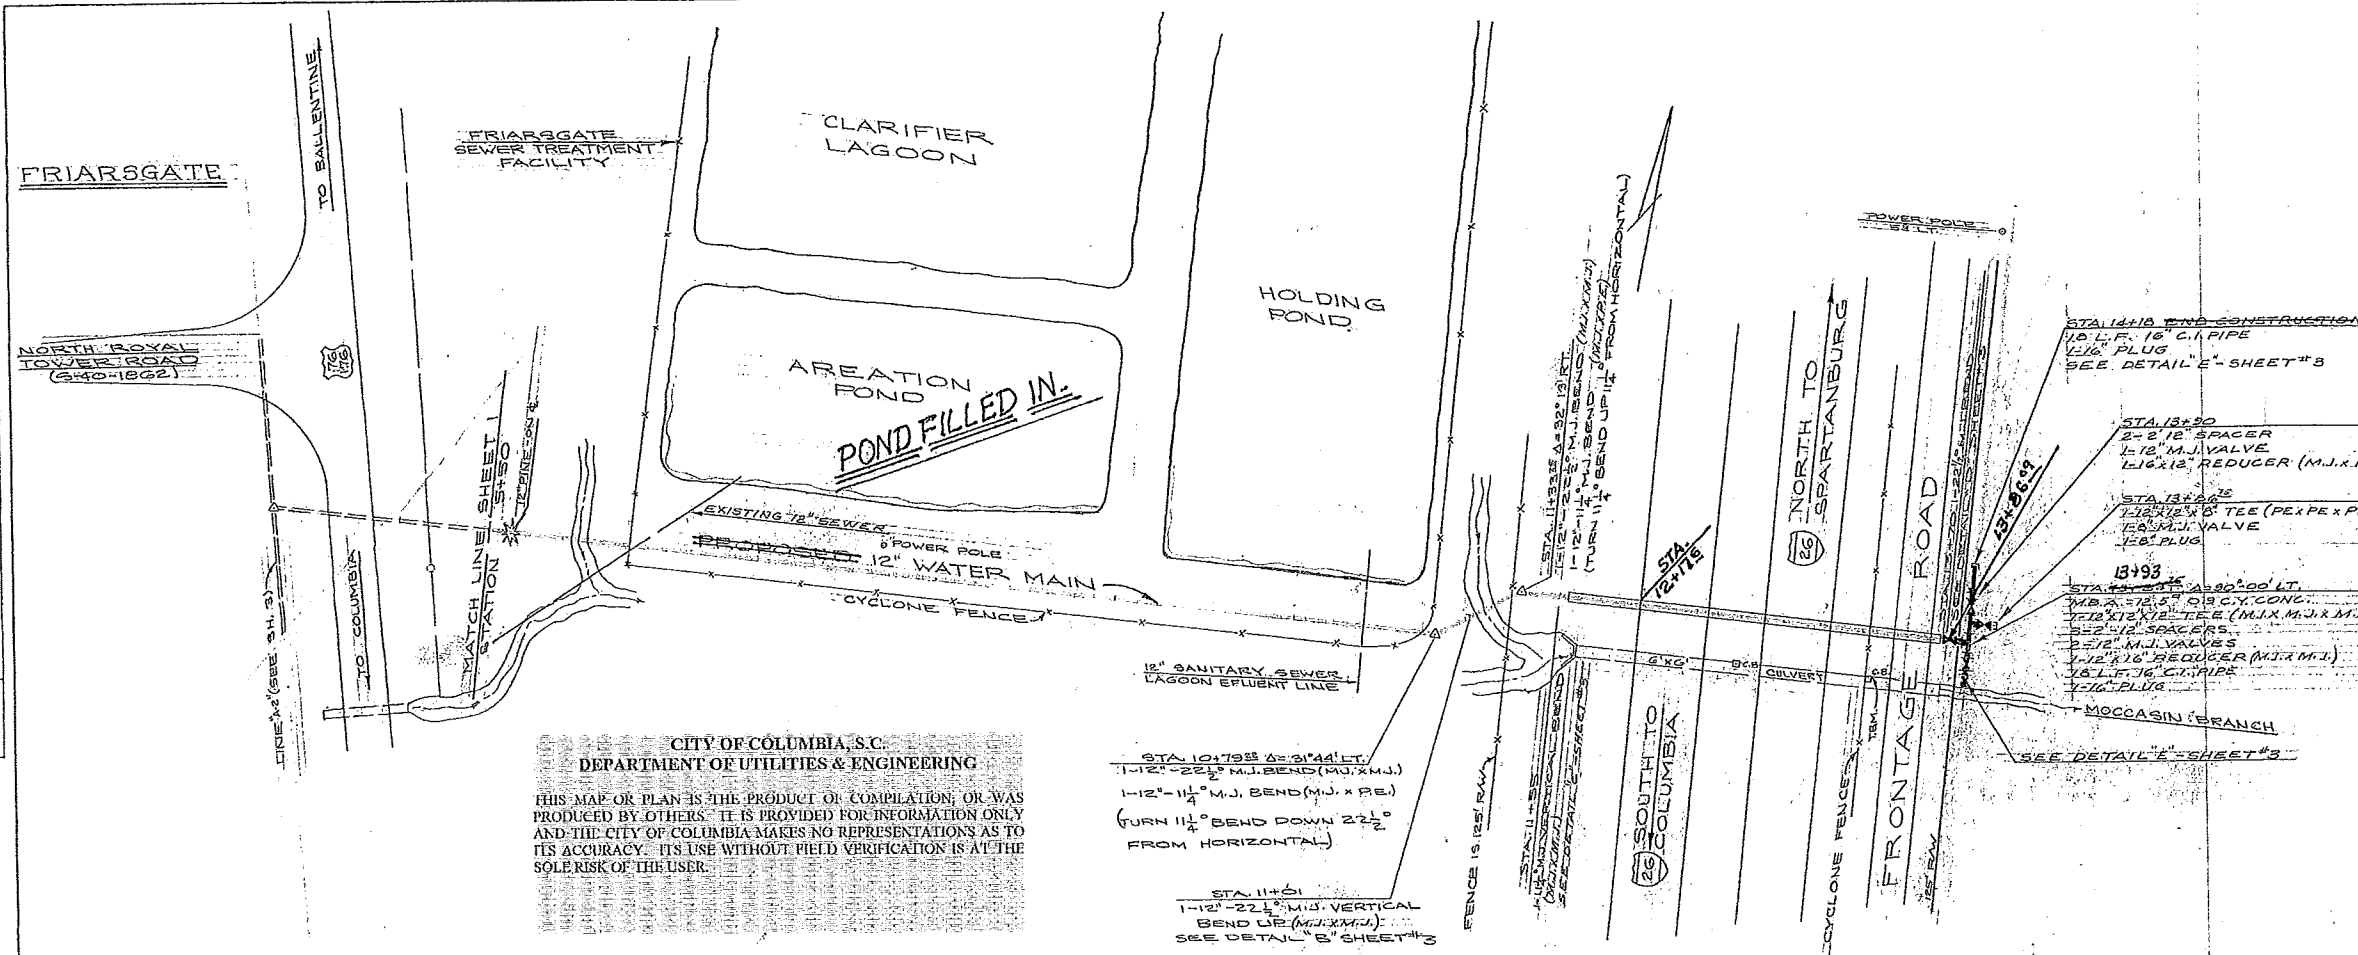

CITY OF COLUMBIA, S.C.
DEPARTMENT OF UTILITIES & ENGINEERING


THIS MAP OR PLAN IS THE PRODUCT OF COMPILED, OR WAS PRODUCED BY OTHERS. IT IS PROVIDED FOR INFORMATION ONLY AND THE CITY OF COLUMBIA MAKES NO REPRESENTATIONS AS TO ITS ACCURACY. ITS USE WITHOUT FIELD VERIFICATION IS AT THE SOLE RISK OF THE USER.

CITY OF COLUMBIA DEPARTMENT OF ENGINEERING COLUMBIA, SOUTH CAROLINA		APPROVED BY:	DESIGNED BY:	REVIEWED BY:	DRAWN BY:
SCALE: AS SHOWN	DATE: 6-6-75				
PROJECT: 12" WATER MAIN					
FRIARGATE TO WESTERN ELECTRIC					
FIELD BOOK NO: 184	DATE SENT TO PUBLIC WORKS: 8-13-75	DATE AS-BUILT RETURNED:	DRAWING NUMBER: 2 OF 3		
CITY ENGINEER	APPROVED BY:	DATE:	REVISION NUMBER AND DESCRIPTION:	DRAWN BY: J.E.D.S.R. 6-15-75	
			REVISED/RECORD DRAWINGS.		

SPECIAL ITEMS THIS SHEET
PLACE 33 C.Y. THRUST BLOCK CONCRETE.

SCALE: 1" = 50' HORIZ.
1" = 5' VERT.

BENCHMARK: ARROW ON HYDRANT AT N.E. CORNER ON NORTH ROYAL TOWER ROAD AND CHARISS CROSS ROAD. EL. 330.32
I.B.M.: 1" ON N.E. CORNER CONCRETE CATCH BASIN RT. OF STA. 13+80 EL. 308.02

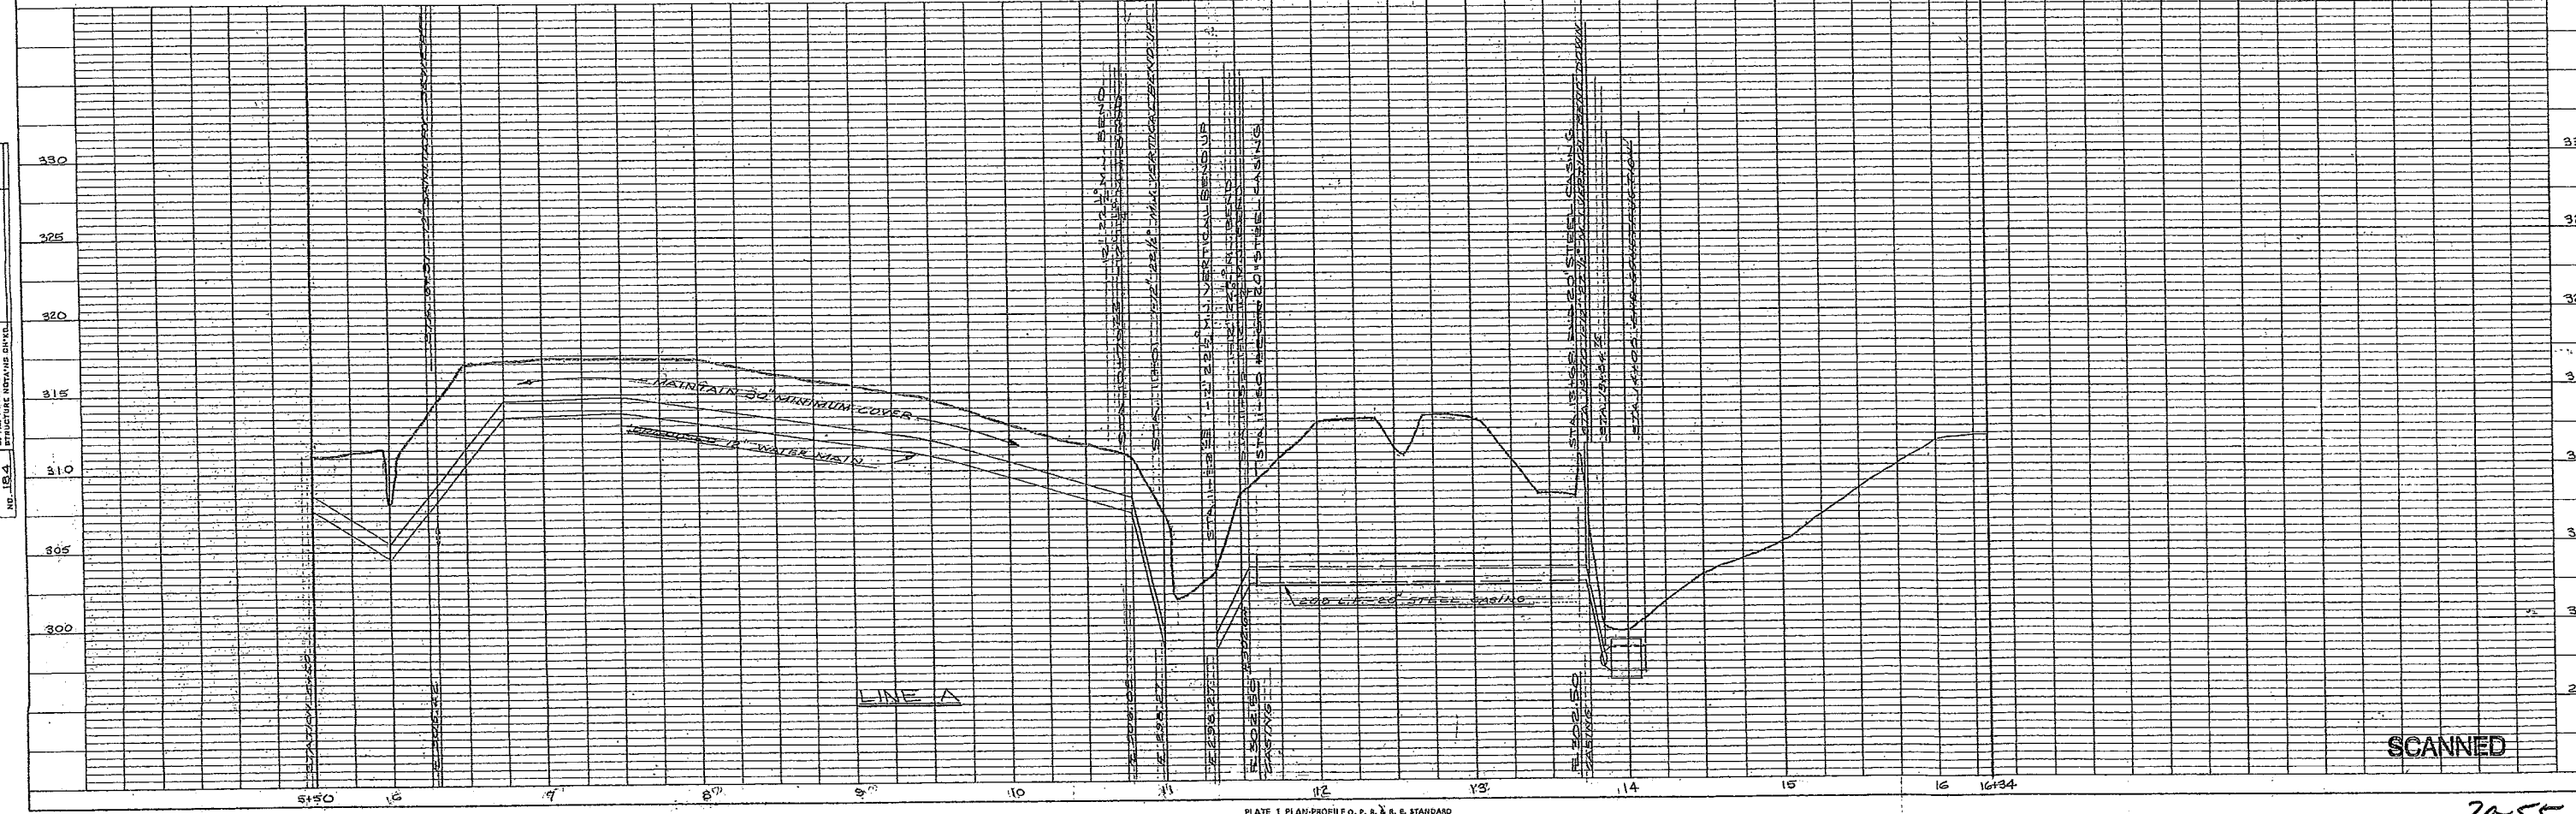

SCANNED

70.55