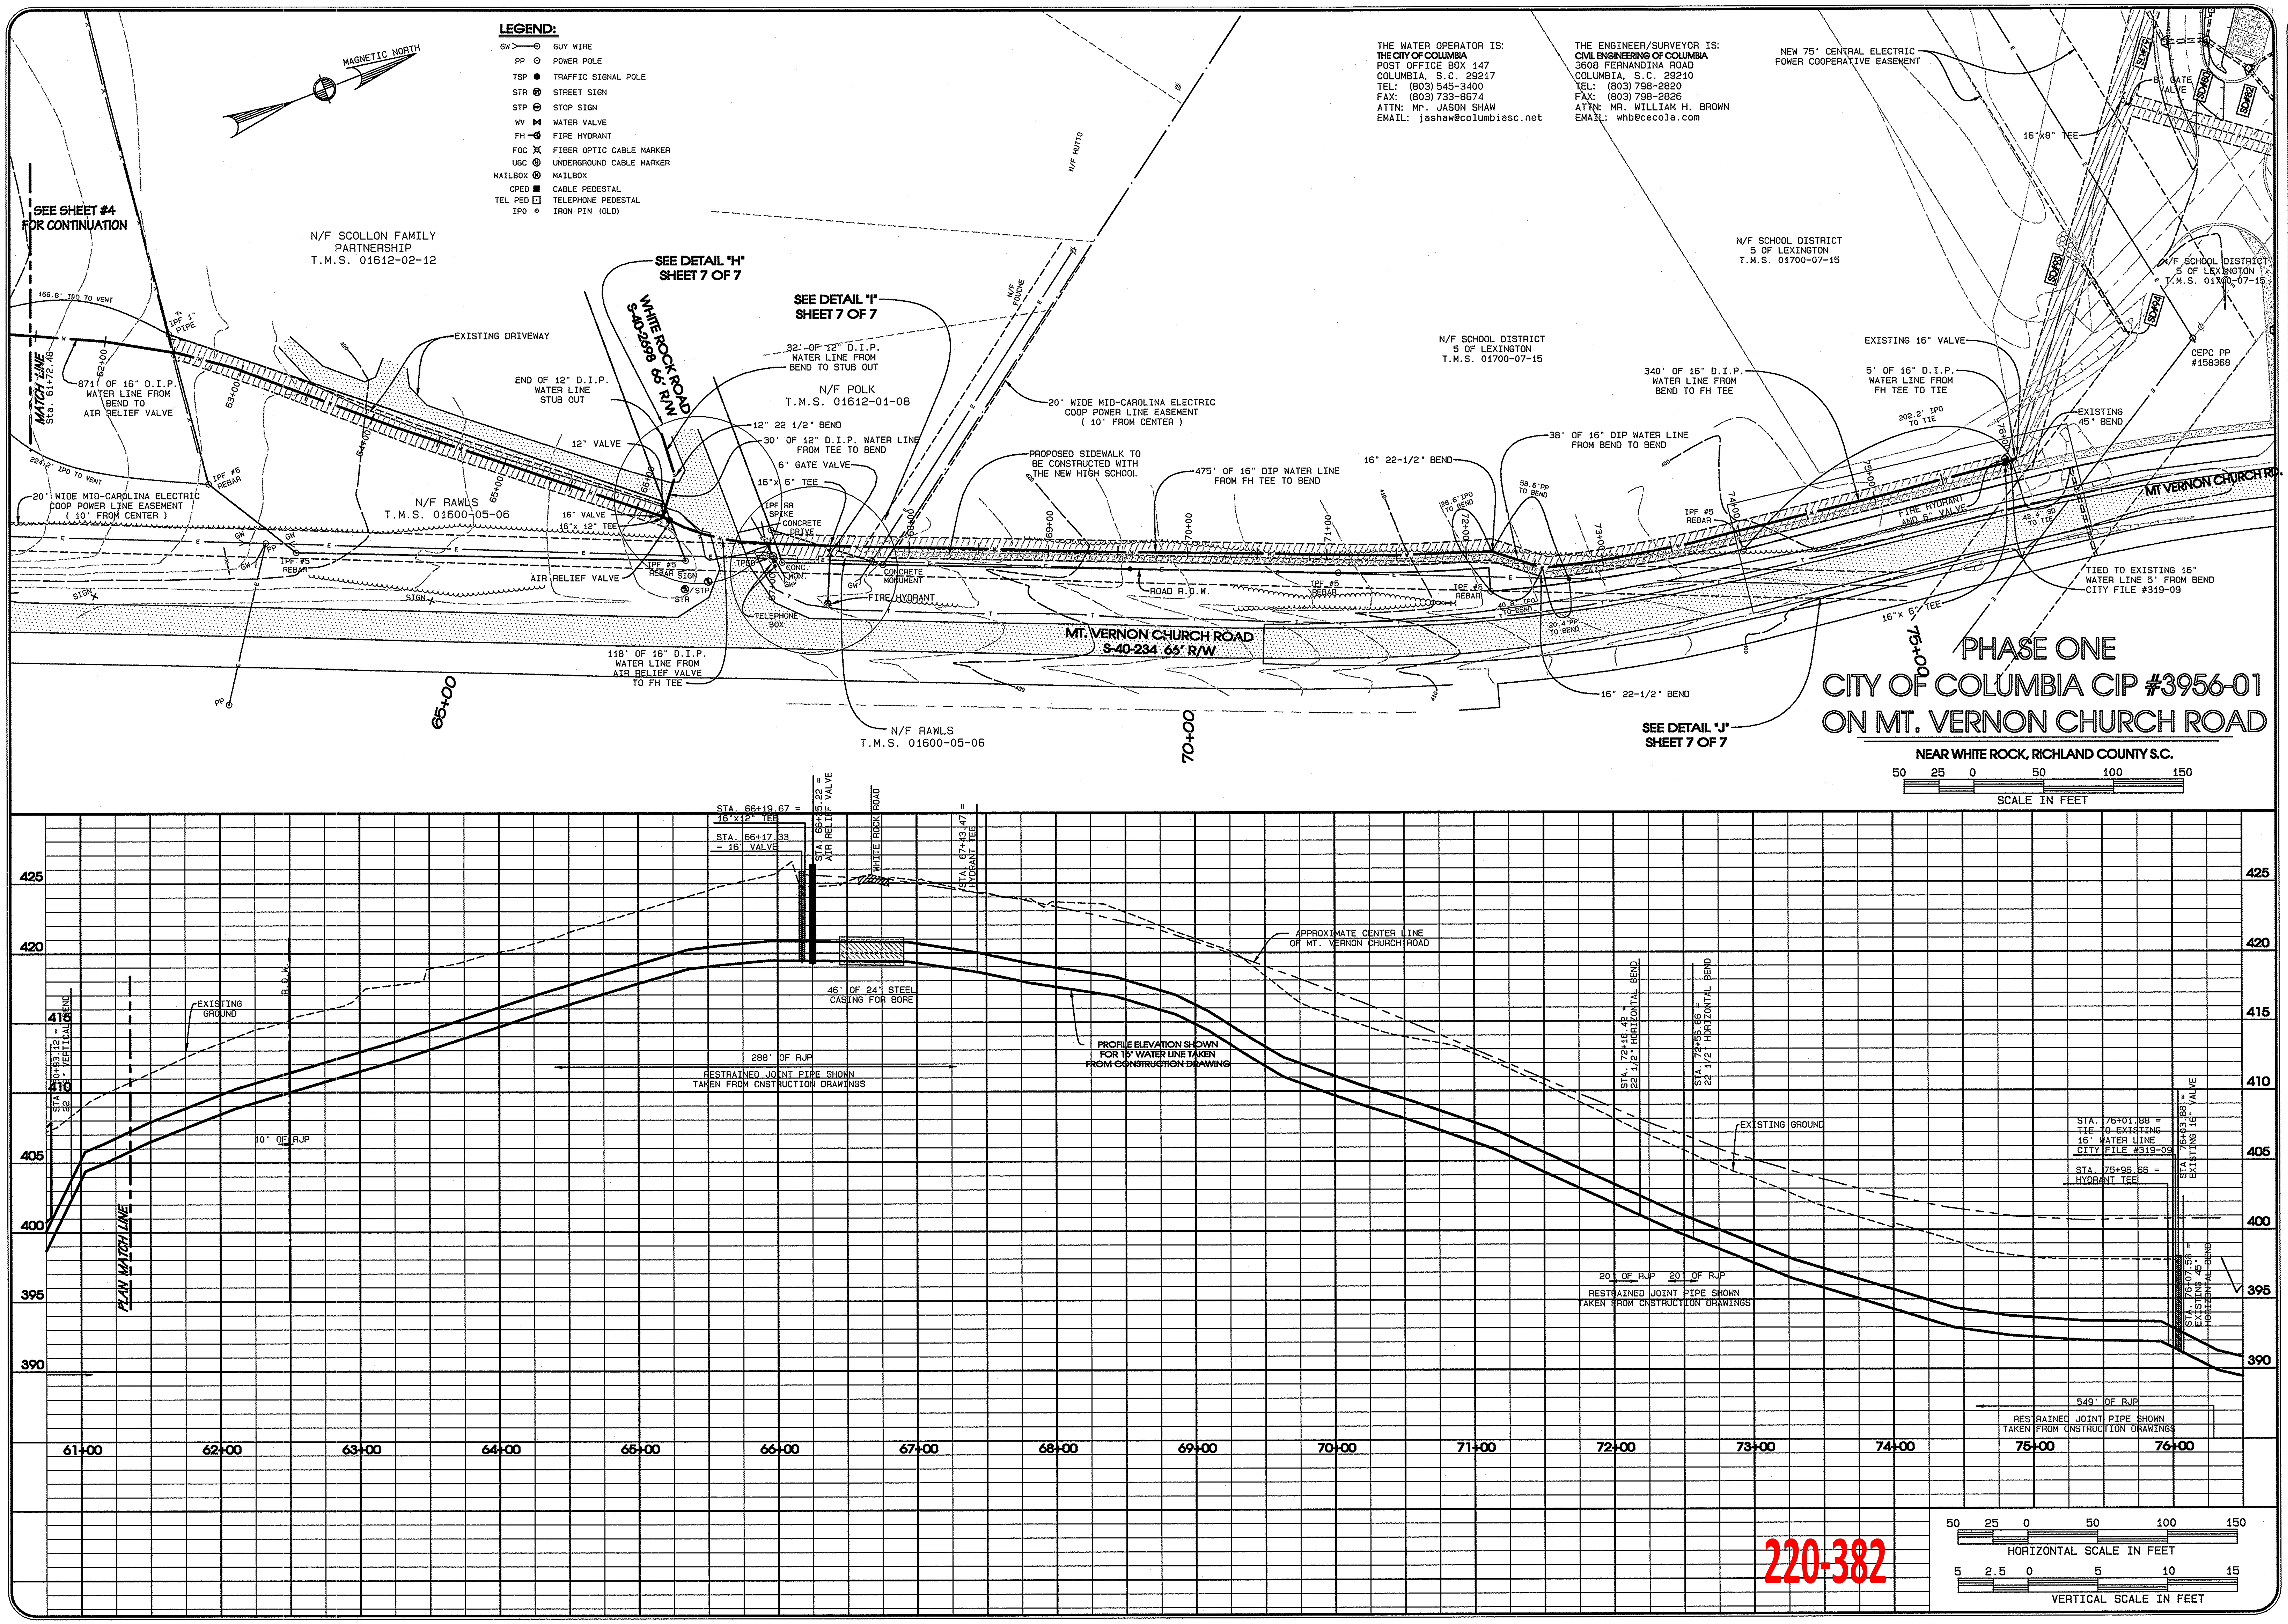

220-382

NO.	DATE	DESCRIPTION	BY
1	03-19-13	REV. DOES NOT APPLY THIS SHEET	HDE

REVISION

SOUTH CAROLINA CIVIL ENGINEERING OF COLUMBIA, INC NO. 000256 CERTIFICATE OF AUTHORIZATION

CIVIL ENGINEERING of COLUMBIA

CONSULTING ENGINEERING, SURVEYING AND PLANNING
3608 FERNANDINA ROAD, COLUMBIA, SOUTH CAROLINA 29210
TELEPHONE (803) 798-2820 FAX (803) 798-2826

ANY CERTIFICATIONS, WARRANTIES, OR GUARANTEES SIGNED BY THE ENGINEER OR SURVEYOR OF RECORD FOR THIS PROJECT ARE INTENDED TO EXPRESS THAT STANDARD AND REASONABLE CARE WERE USED IN PREPARATION OF THESE DOCUMENTS.

SOUTH CAROLINA REGISTERED PROFESSIONAL ENGINEER & LAND SURVEYOR NO. 4953 WILLIAM H. BROWN

3/19/13

WATER RECORD DRAWING

PREPARED FOR
THE CITY OF COLUMBIA
COLUMBIA, SOUTH CAROLINA

CHECKED BY:

JOB NUMBER 10042

SCALE AS SHOWN
DATE FEB. 11, 2013
DRAWN HDE
DESIGNED DINKINS
DRAWING NUMBER 6 OF 7

CIP #WM3956-01