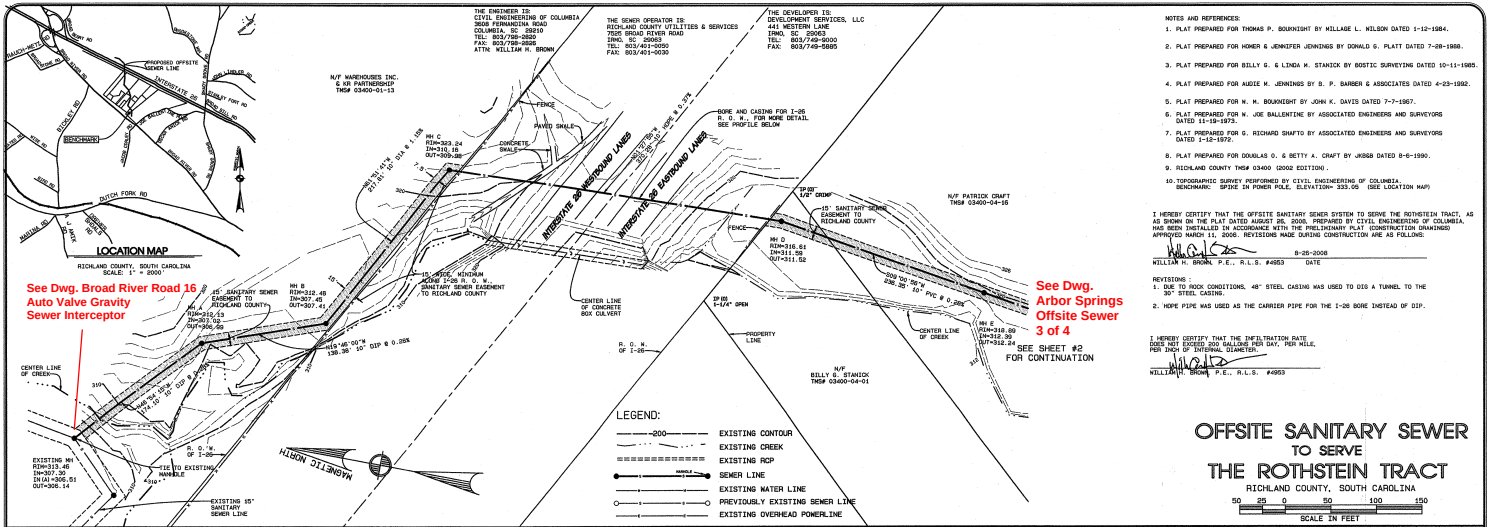

NO.	DATE	REVISION	BY

CIVIL ENGINEERING of COLUMBIA
CONSULTING ENGINEERING, SURVEYING AND PLANNING
3608 FERNANDINA ROAD, COLUMBIA, SOUTH CAROLINA 29210
PHONE: (803) 798-2830 FAX: (803) 798-3826

ANY CONTRACTOR, SUBCONTRACTOR, OR SUBSURFACE UTILITY LOCATING AGENCY USING THESE PLANS FOR ANY PURPOSE SHALL BE RESPONSIBLE FOR VERIFYING THE ACCURACY OF THE DATA PRIOR TO CONSTRUCTION OR INSTALLATION OF THESE DOCUMENTS.
THE PRODUCT OF THIS SURVEY WAS PREPARED IN ACCORDANCE WITH THE REQUIREMENTS OF THE SC. MINIMUM STANDARDS MANUAL FOR THE PRACTICE OF LAND SURVEYING IN SOUTH CAROLINA, AND MEETS OR EXCEEDS THE REQUIREMENTS FOR A CLASS A SURVEY AS SPECIFIED THEREIN.
© COPYRIGHT 2006 CIVIL ENGINEERING OF COLUMBIA
ALL RIGHTS RESERVED. THIS DRAWING IS THE PROPERTY OF CIVIL ENGINEERING OF COLUMBIA AND IS NOT TO BE USED IN WHOLE OR IN PART FOR ANY OTHER PROJECT WITHOUT THE WRITTEN AUTHORIZATION OF CIVIL ENGINEERING OF COLUMBIA. ANY UNAUTHORIZED USE IS STRICTLY PROHIBITED.

SANITARY SEWER RECORD DRAWING
PREPARED FOR
RICHLAND COUNTY UTILITIES AND SERVICES
COLUMBIA, SOUTH CAROLINA

SCALE	AS NOTED
DATE	AUG 25, 2006
DRAWN	C. S.
DESIGNED	SPANGLER
CHECKED By:	
JOB NUMBER	03161
DRAWING NUMBER	1 OF 3